


340 N Westlake Boulevard
Suite 250
Westlake Village
California 91362
805 496-1101
805 494-1421 Fax
email bba@behrbrowsers.com

ARCHITECTURE
URBAN DESIGN
PLANNING
INTERIORS

These drawings are the instruments of service and are the property of Behr-Browsers Architects, Inc. All design and other information contained on these drawings are for use on the specified project and shall not be used on other projects, or for additions to this project, or for completion of this project by others without first obtaining the expressed written permission and consent of Behr-Browsers Architects, Inc. These drawings shall not be reproduced, changed or copied in any form or whatsoever without first obtaining the expressed written permission and consent of Behr-Browsers Architects, Inc. nor are they to be assigned to any third party without said written permission and consent.
Copyright © Behr-Browsers Architects, Inc.
All Rights Reserved.
Stamp

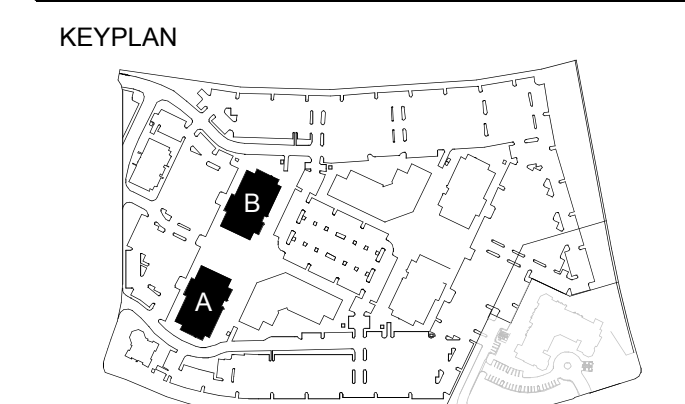

- NOTES:
- 1) FOR TYPICAL NOTES SEE SHEET G0101, G0201, G0202, G0301, G0302
 - 2) FOR MATERIALS LIST SEE SHEET A7001
 - 3) ALL WALLS FOR BUILDINGS B & F SHALL BE 1-HR RATED AND EXTEND TO UNDERSIDE OF FLOOR/ROOF OF DECK ABOVE UNLESS NOTED OTHERWISE.
 - 4) ALL DIMENSIONS TO FACE OF STUD UNLESS NOTED OTHERWISE.
- ☒ FIRE EXTINGUISHER CABINET
 - INDICATES WALLS COMPRISING TUNNEL CONSTRUCTION SEE DETAIL 13/A&M01
 - INDICATES WALLS OF 2-HR SHAFT CONSTRUCTION
 - ⊗ INDICATES INTERIOR ELEVATION, SEE SHEETS A6001-A6023
 - ⊗ INDICATES TACTILE EXIT SIGNAGE, FOR LEGEND SEE SHEET 04/G0302
 - AD AREA DRAIN


08.07.06 PLAN CHECK CORRECTIONS
03.31.06 ISSUED FOR PLAN CHECK
03.10.06 PROGRESS PRINT
02.10.06 PROGRESS PRINT
01.20.06 PROGRESS PRINT

Revisions
Job Name / Job Address
**WESTLAKE
PARK PLACE**
BLDG A = 2945 TOWNSGATE RD.
BLDG B = 3027 TOWNSGATE RD.
BLDG F = 3011 TOWNSGATE RD.
BLDG H = 2915 TOWNSGATE RD.
BLDG I = 2931 TOWNSGATE RD.
THOUSAND OAKS, CA

Job Number 32602.00 Drawn JRO/AW/JDM/X
Date 9/14/06 3:52 PM

Sheet Title
**BLDG B -
GROUND LEVEL
REFERENCE PLAN
(BLDG A OPP)**
A2101

Scale: 1/8" = 1'-0"
0 8 16 32

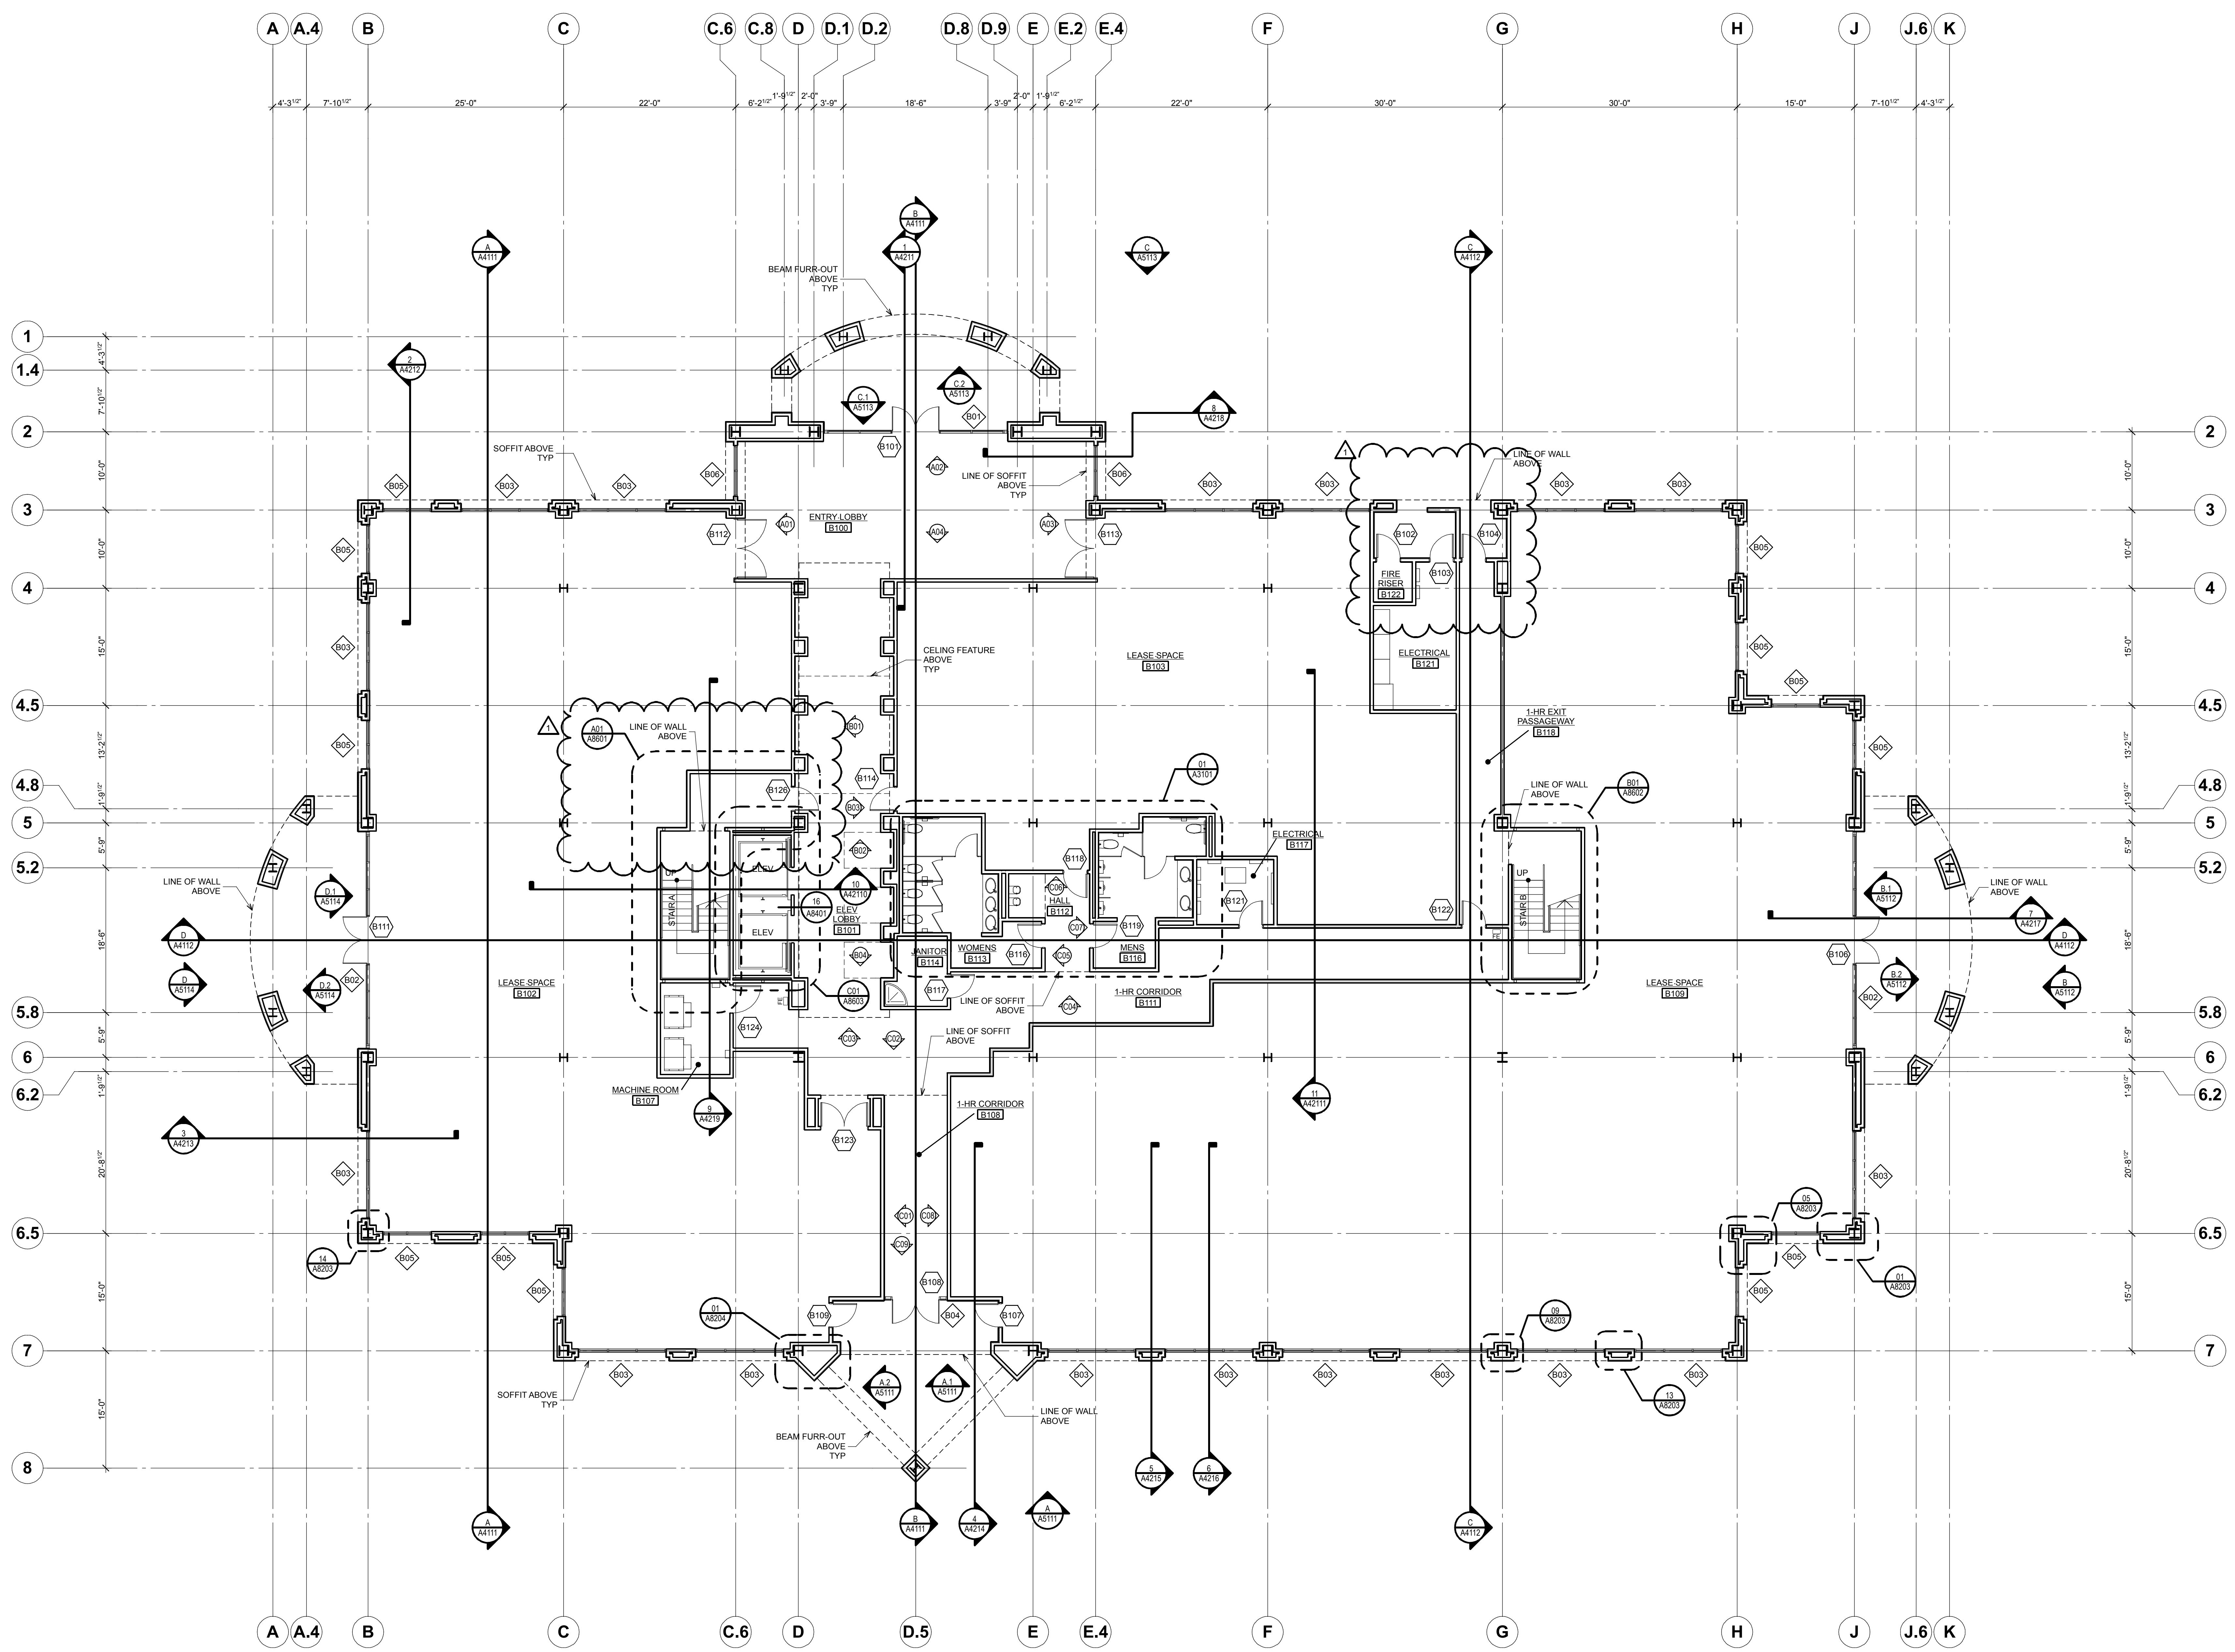

BLDG B - GROUND LEVEL REFERENCE PLAN
1/8" = 1'-0"